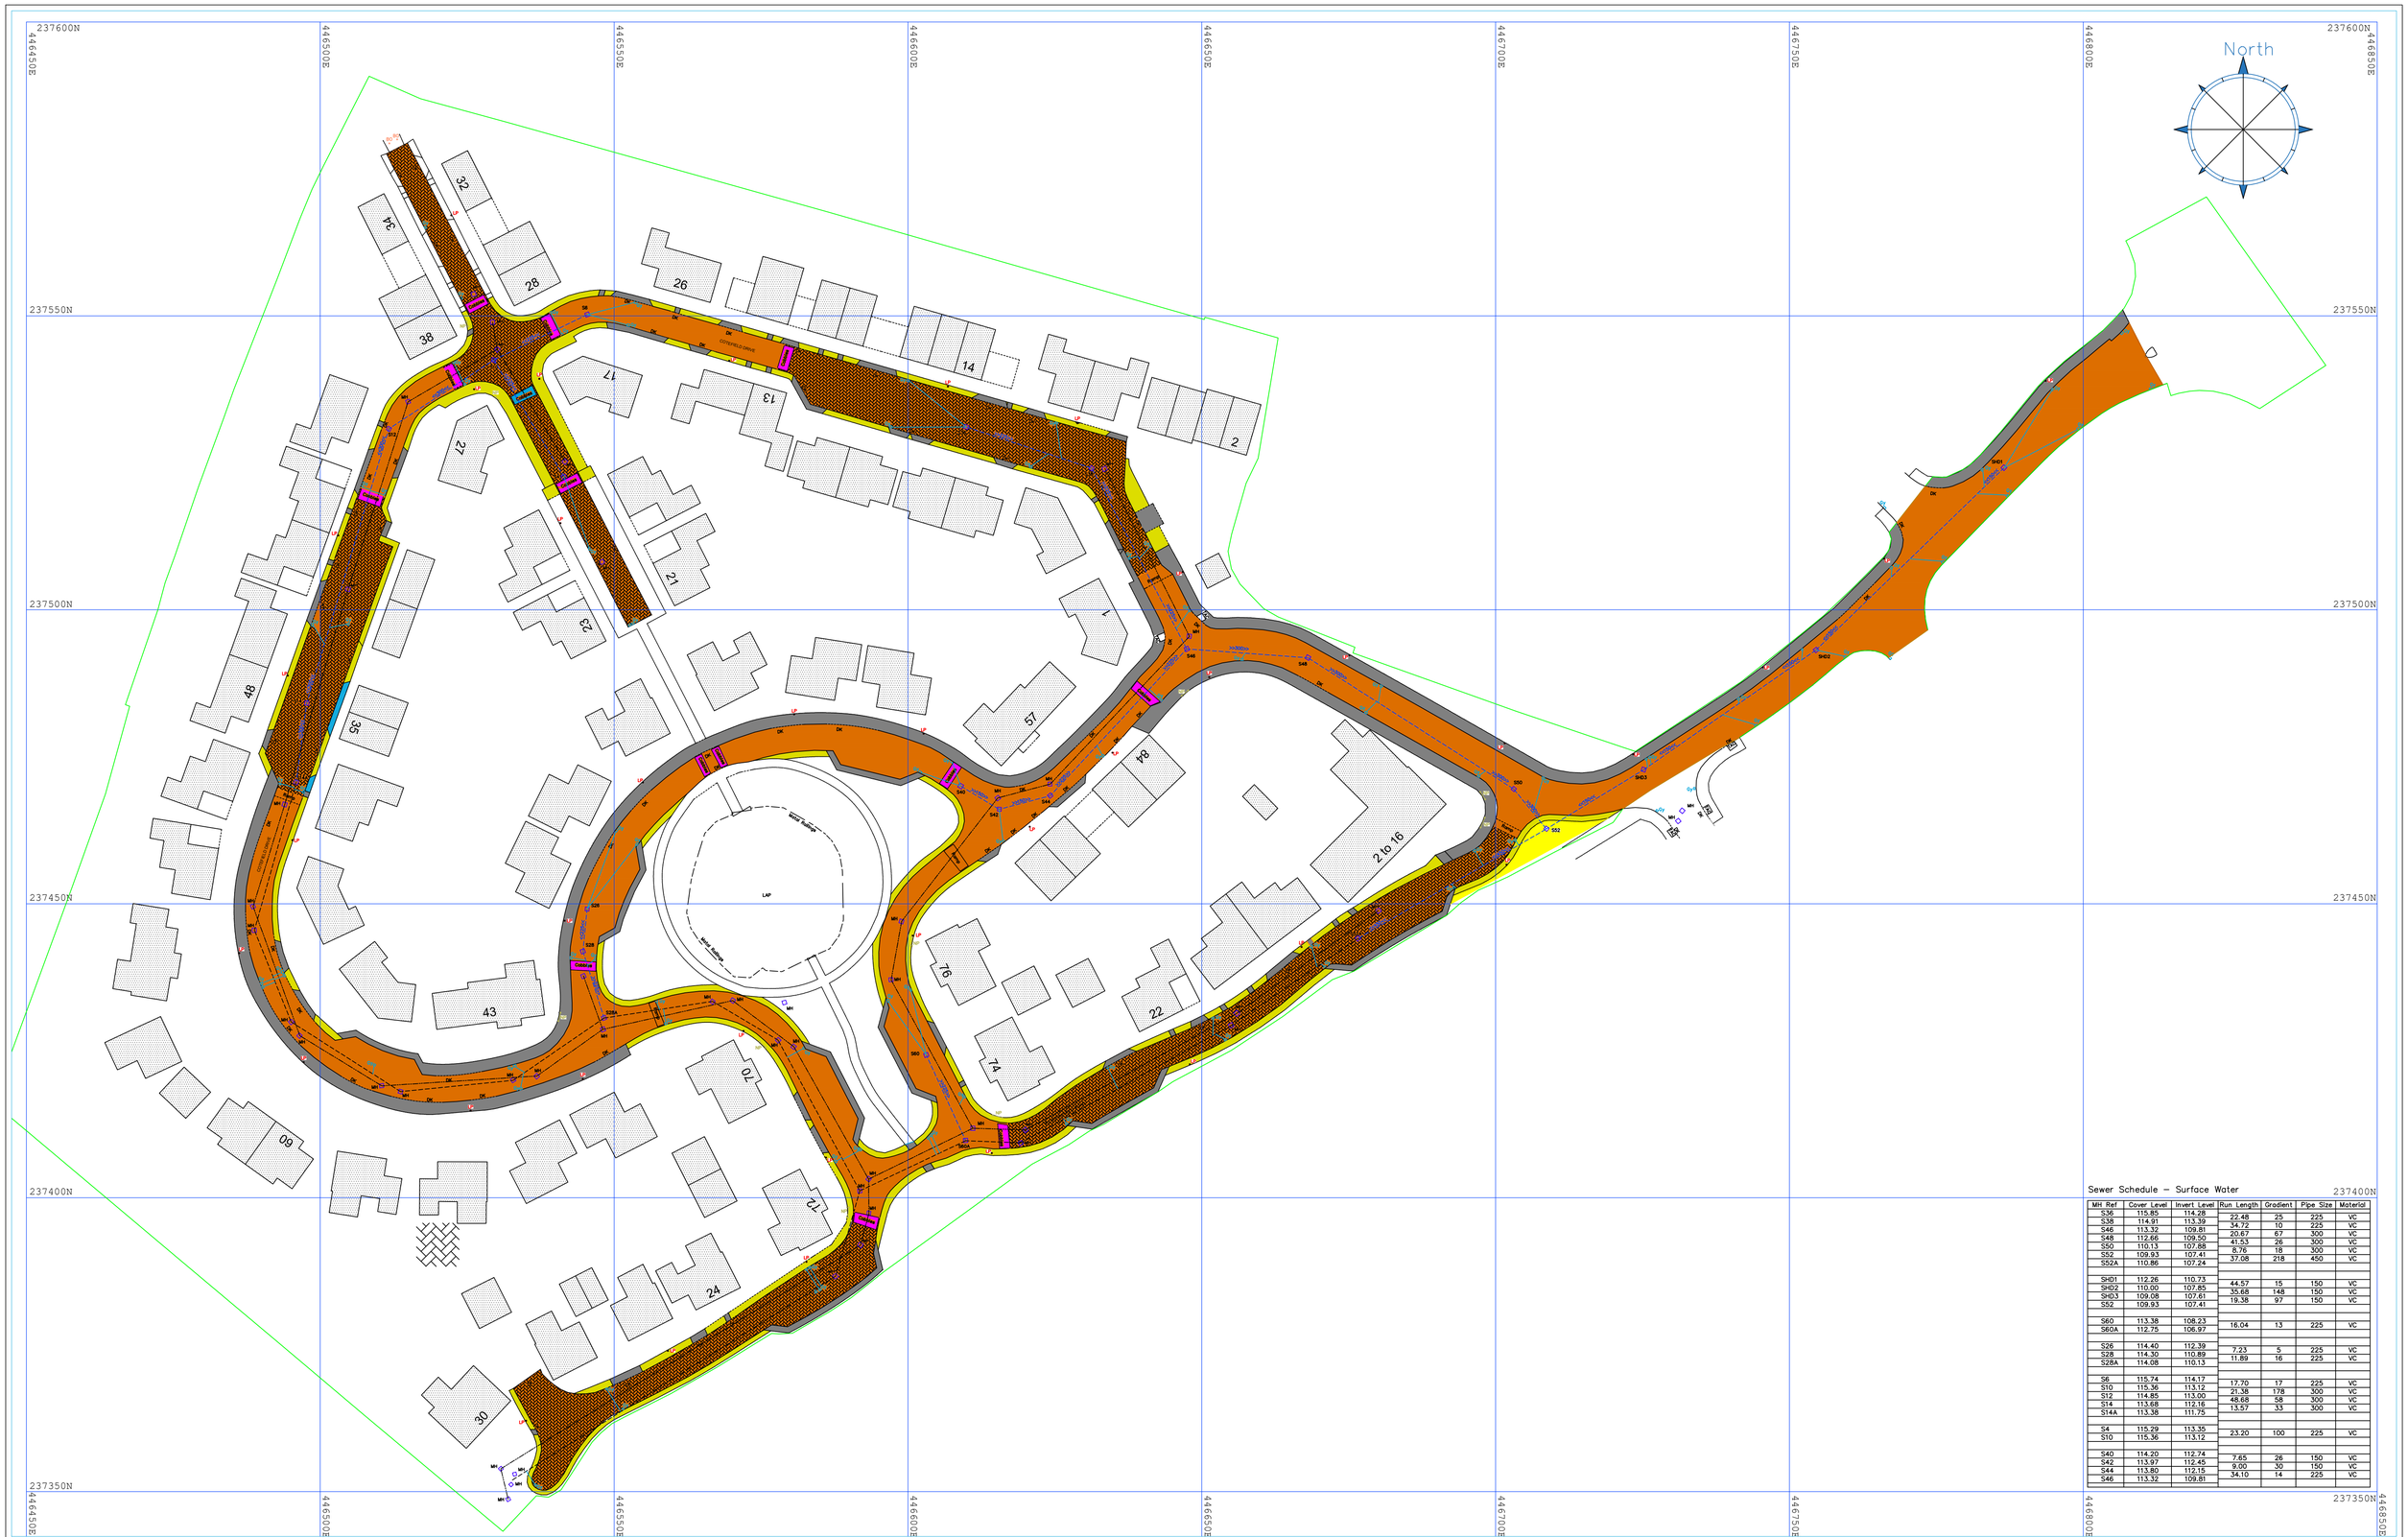

Sewer Schedule – Surface Water

MH Ref	Cover Level	Invert Level	Run Length	Gradient	Pipe Size	Material
S36	115.85	114.28	22.48	25	225	VC
S38	114.91	113.39	34.72	10	225	VC
S46	113.32	109.81	20.67	67	300	VC
S48	112.66	109.50	41.53	26	300	VC
S50	110.13	107.88	8.76	18	300	VC
S52	109.93	107.41	37.08	218	450	VC
S52A	110.86	107.24				
SHD1	112.26	110.73	44.57	15	150	VC
SHD2	110.00	107.85	35.68	148	150	VC
SHD3	109.08	107.61	19.38	97	150	VC
S52	109.93	107.41				
S60	113.38	108.23	16.04	13	225	VC
S60A	112.75	106.97				
S26	114.40	112.39	7.23	5	225	VC
S28	114.30	110.89	11.89	16	225	VC
S28A	114.08	110.13				
S6	115.74	114.17	17.70	17	225	VC
S10	115.36	113.12	21.38	178	300	VC
S12	114.85	113.00	48.68	58	300	VC
S14	113.68	112.16	13.57	33	300	VC
S14A	113.38	111.75				
S4	115.29	113.35	23.20	100	225	VC
S10	115.36	113.12				
S40	114.20	112.74	7.65	26	150	VC
S42	113.97	112.45	9.00	30	150	VC
S44	113.80	112.15	34.10	14	225	VC
S46	113.32	109.81				

Location
Project Location

Requirement
As Constructed Survey – Section 38

Client
Your Company Name here

Notes
Position & level fixed to OSGB(15) Grid. Scale factor value 1.0 applies
All dimensions should be checked on site prior to construction.
Where invert levels are shown, depths/pipe sizes have been obtained without entry.
This drawing is subject to Copyright and should not be duplicated or altered without the consent of William Morris Surveys Limited or the "Client".

Reference 0001–001 | Scale 1:500@A1
Initial CM | Date 01–01–21

Legend

BH	Bore Hole	F–PW	Post & Wire Fence	TAC	Tactile Paving
BT	BT Cover	F–SB	Security Fence	TP	Telegraph Pole
CH	Chamber	FH	Fire Hydrant	TS	Traffic Signal
BW	Block Paving	FL	Finish Level	UL	Up Light
CAB	Cabinet	GT	Gate		
CB	Collapsable Bollard	GY	Gully	>150>	Flow Direction & Pipe Size
CTV	Cable TV Cover	I–B	Illuminated Bollard		
DK	Drop Kerb	IC–C	Inspection Chamber (Combined)		
DP	Down Pipe	IC–F	Inspection Chamber (Foul)		
DPC	Damp Proof Course	IC–S	Inspection Chamber (Surface Water)		
EB	Electric Box	LP	Lamp Post		
EP	Electricity Pole	LP	Lamp Post		
ER	Earth Rod	MH–C	Manhole (Combined)		
FB	Flower Bed	MH–F	Manhole (Foul)		
F–BW	Barbed Wire Fence	MH–S	Manhole (Surface Water)		
F–CB	Close Boarded Fence	NP	Name Plate		
F–CL	Chain Link Fence	PM	Parking Meter		
F–HR	Knee Rail	PO	Post		
F–HT	Hedge Trimmed	SCB	Signal Control Box		
F–MR	Metal Railings	SP	Sign Post		
F–PI	Picket Fence	SV	Stop Valve		
F–PR	Post & Rail Fence	SVG	Stop Valve (Gas)		

Symbols & Hatches
Building
Concrete
Grass/Shrubs
Block Paving
Wall
Spot Level
Survey Station
Tadpole (Bank Detail)
Tree (to scale) & Height

Section 38 Legend
Adoptable Footway/Crossover
Adoptable Highway
Adoptable Grass Verge
S38 Highway Easement
S38 Cobble/Rumble Strip
Lamp Column
Gully & Connection
Gully & Connection
Highway Sewer
>pi150>> Pipe Size & Flow
Site Boundary

Survey Control

William Morris Surveys Limited
17 Lees Lane
South Normanton
Alfreton
Derbyshire
DE55 2AD

Office. 0800 002 5517
www.williammorrissurveys.co.uk

William Morris Surveys